JEFFERSON COUNTY DEPARTMENT OF HEALTH AND ENVIRONMENT
260 S KIPLING ST. LAKEWOOD, CO 80226 (303) 239-7175 **FAX** (303) 239-7076

INDIVIDUAL SEWAGE DISPOSAL SYSTEM SITE INSTALLATION PLAN PERMIT #18112

ADDRESS:	28237 Belle Vista Drive
LEGAL:	Lot 5, Belle Meade Subdivision
OWNER/APPLICANT:	Design Ideas, Inc.
SYSTEM DESIGNED FOR:	5 Bedroom Single Family Dwelling

SEPTIC TANK SIZE (gal) 1,500 ABSORPTION BED SIZE (ft^2)1,200

The individual sewage disposal system on this property was installed in accordance with the permit conditions and the Individual Sewage Disposal System Regulations of Jefferson County, Colorado.

INSPECTOR _____ FINAL APPROVAL DATE 3-23-2000

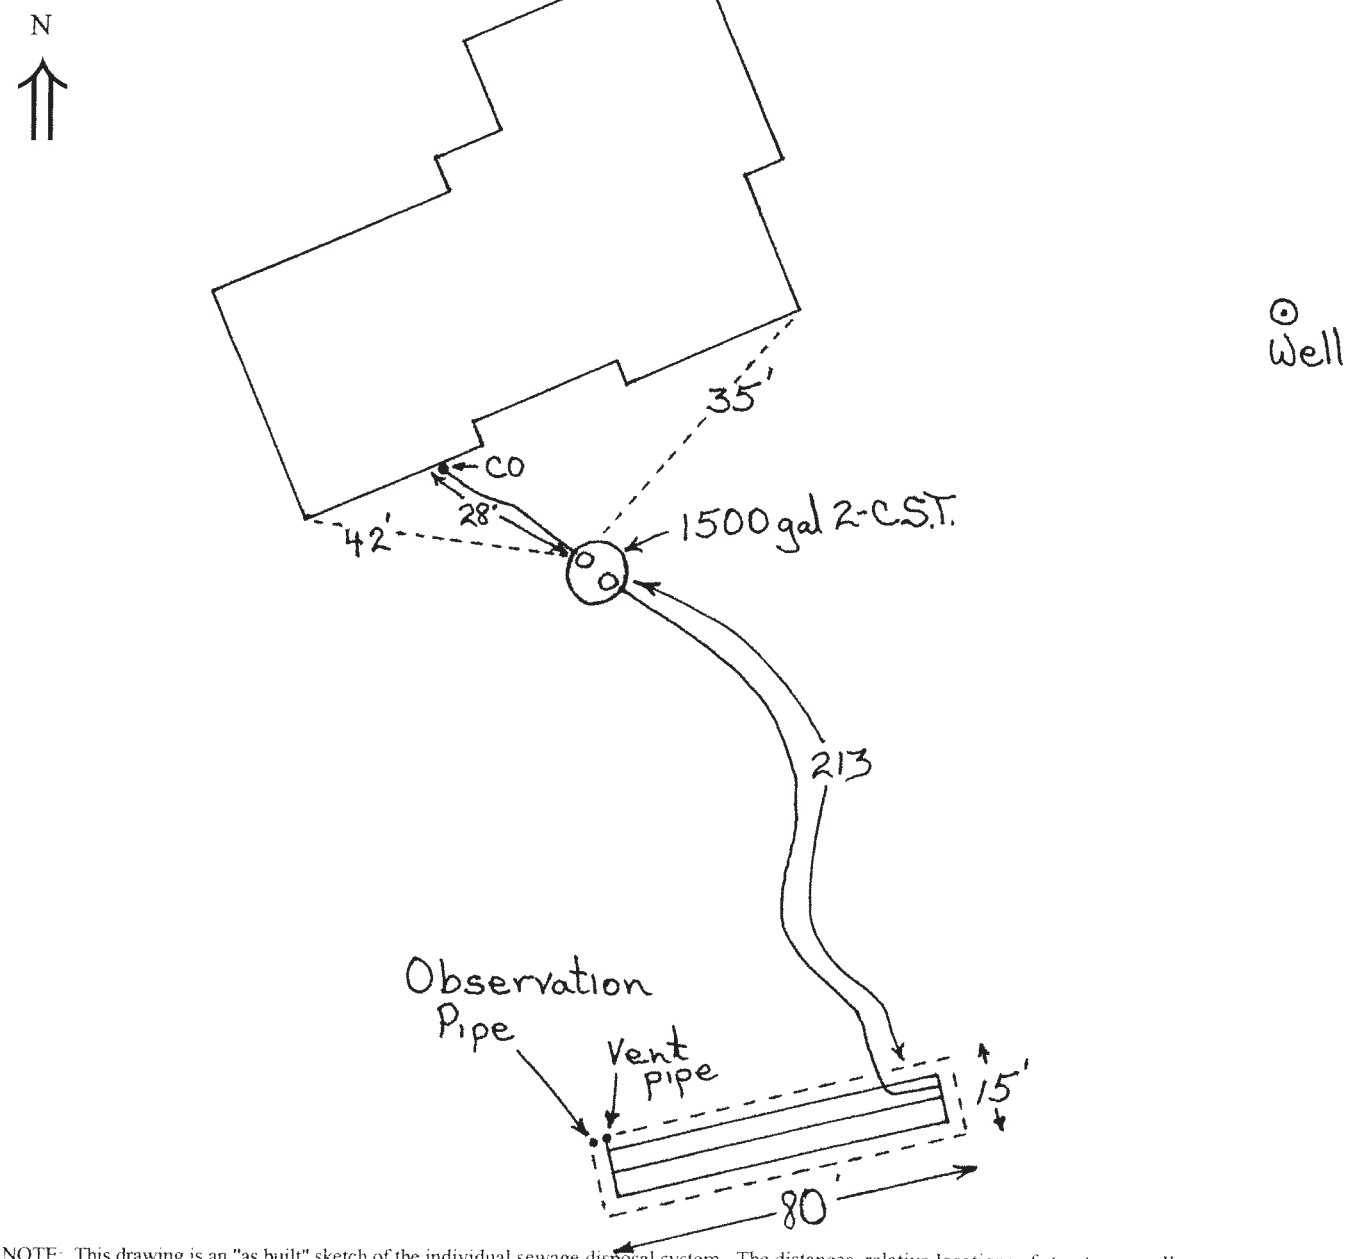

NOTE: This drawing is an "as built" sketch of the individual sewage disposal system. The distances, relative locations of structures, wells, system components and compass directions are approximate.